

RALPH P. VOLPE
Chairman

HUNTER R. ROBINSON
Vice-Chairman

JACK D. GULATI

WILLIAM M. SMITH

ROBERT J. MONTEMAYOR

RONALD G. WAGENMANN
Township Manager

Firm of
MENESES & DEAN, P.C.
Attorneys at Law
Township Solicitor

BENJAMIN M. HATCH, P.E.
Township Engineer

**SUPERVISORS OF
UPPER MERION TOWNSHIP
KING OF PRUSSIA, PA. 19406**



Cross Roads of History and Tomorrow

ENGINEERING & BUILDING DEPT.

(215) 265-2606

June 8, 1984

Valley Forge Historical Society
Valley Forge, PA

ATTN: Ms. Mead,
President

Last week I inspected the museum at the George Washington Memorial Chapel and noticed that a renovation is taking place. Although generally you are in good shape, I do have some recommendations. Enclosed please find a copy of the floor plan of the museum with my observations. They include:

1. The installation of illuminated exit signs, with back-up power, at the locations indicated.
2. The interruption of the stairs to the basement to prevent its use by visitors.



When the renovations are completed, please contact me to reinspect and to calculate for you a proper occupant load. Thank you in advance for your co-operation. If you have any questions, please feel free to contact me at 265-2608.

Sincerely,


JOHN R. WATERS
FIRE MARSHAL
UPPER MERION TOWNSHIP

JRW:mp


What a man does for himself dies with him; what a man does for his community lives on...

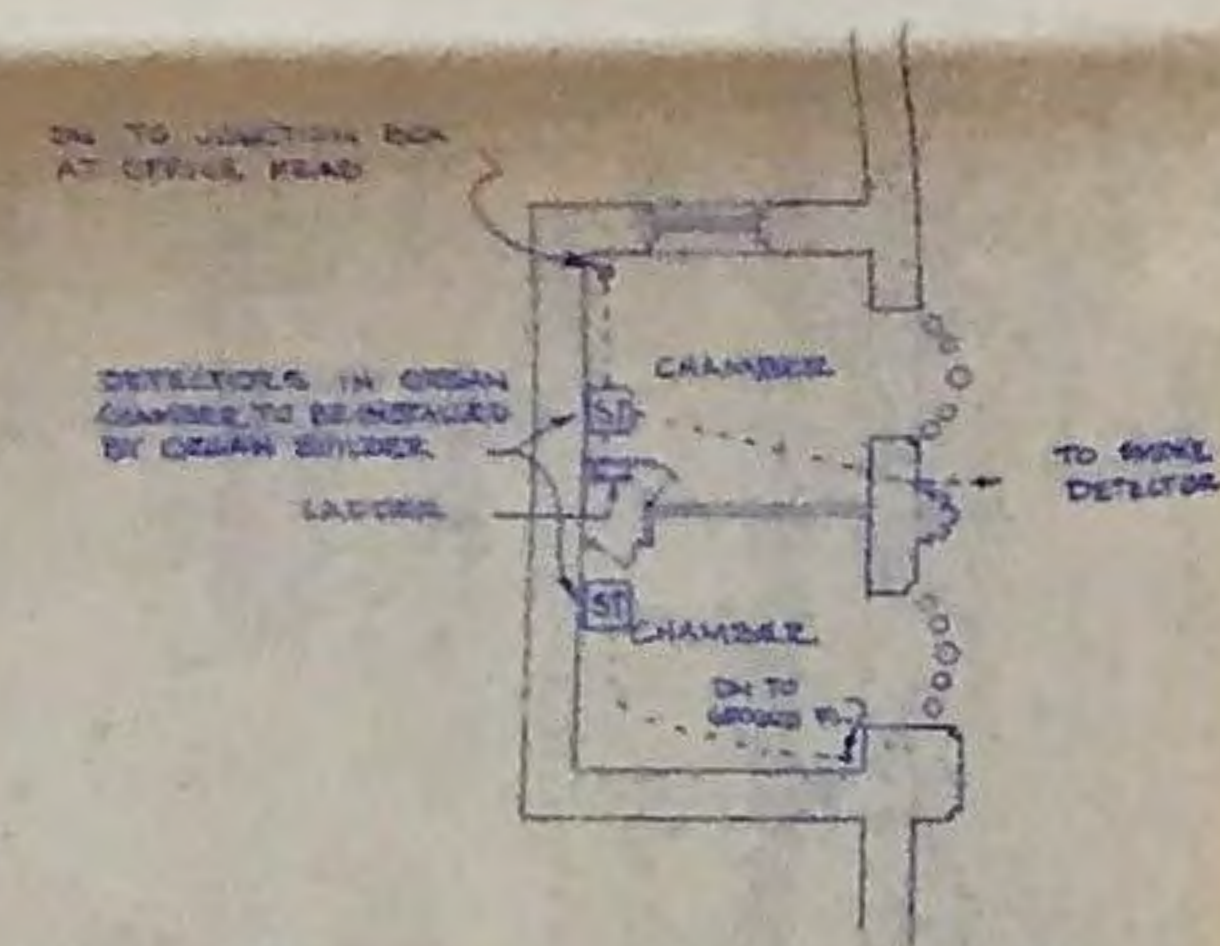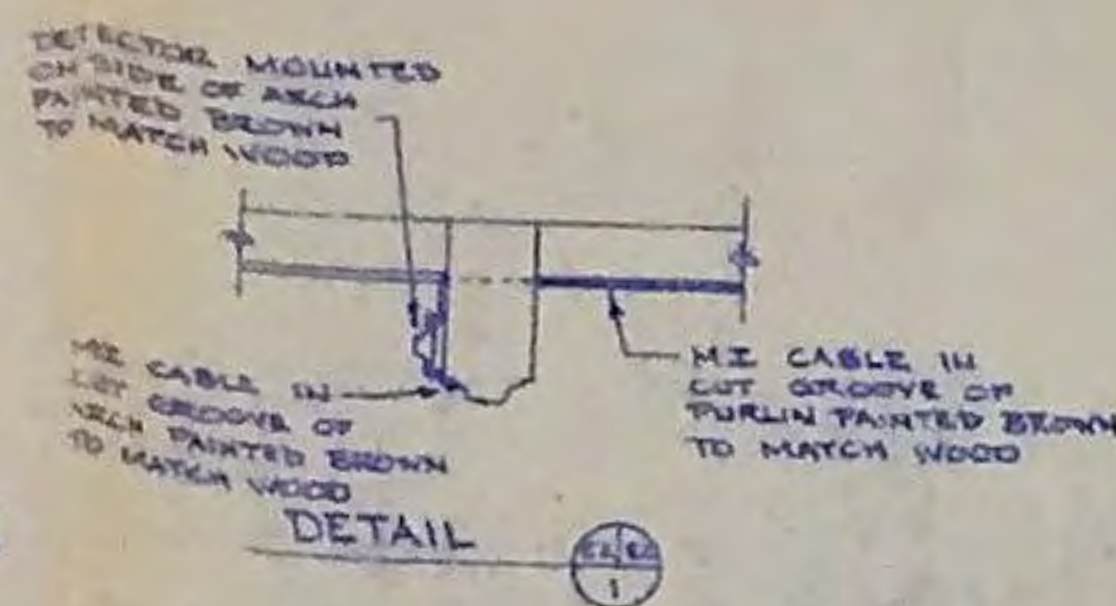


ORGAN CHAMBER
ABOVE OFFICE

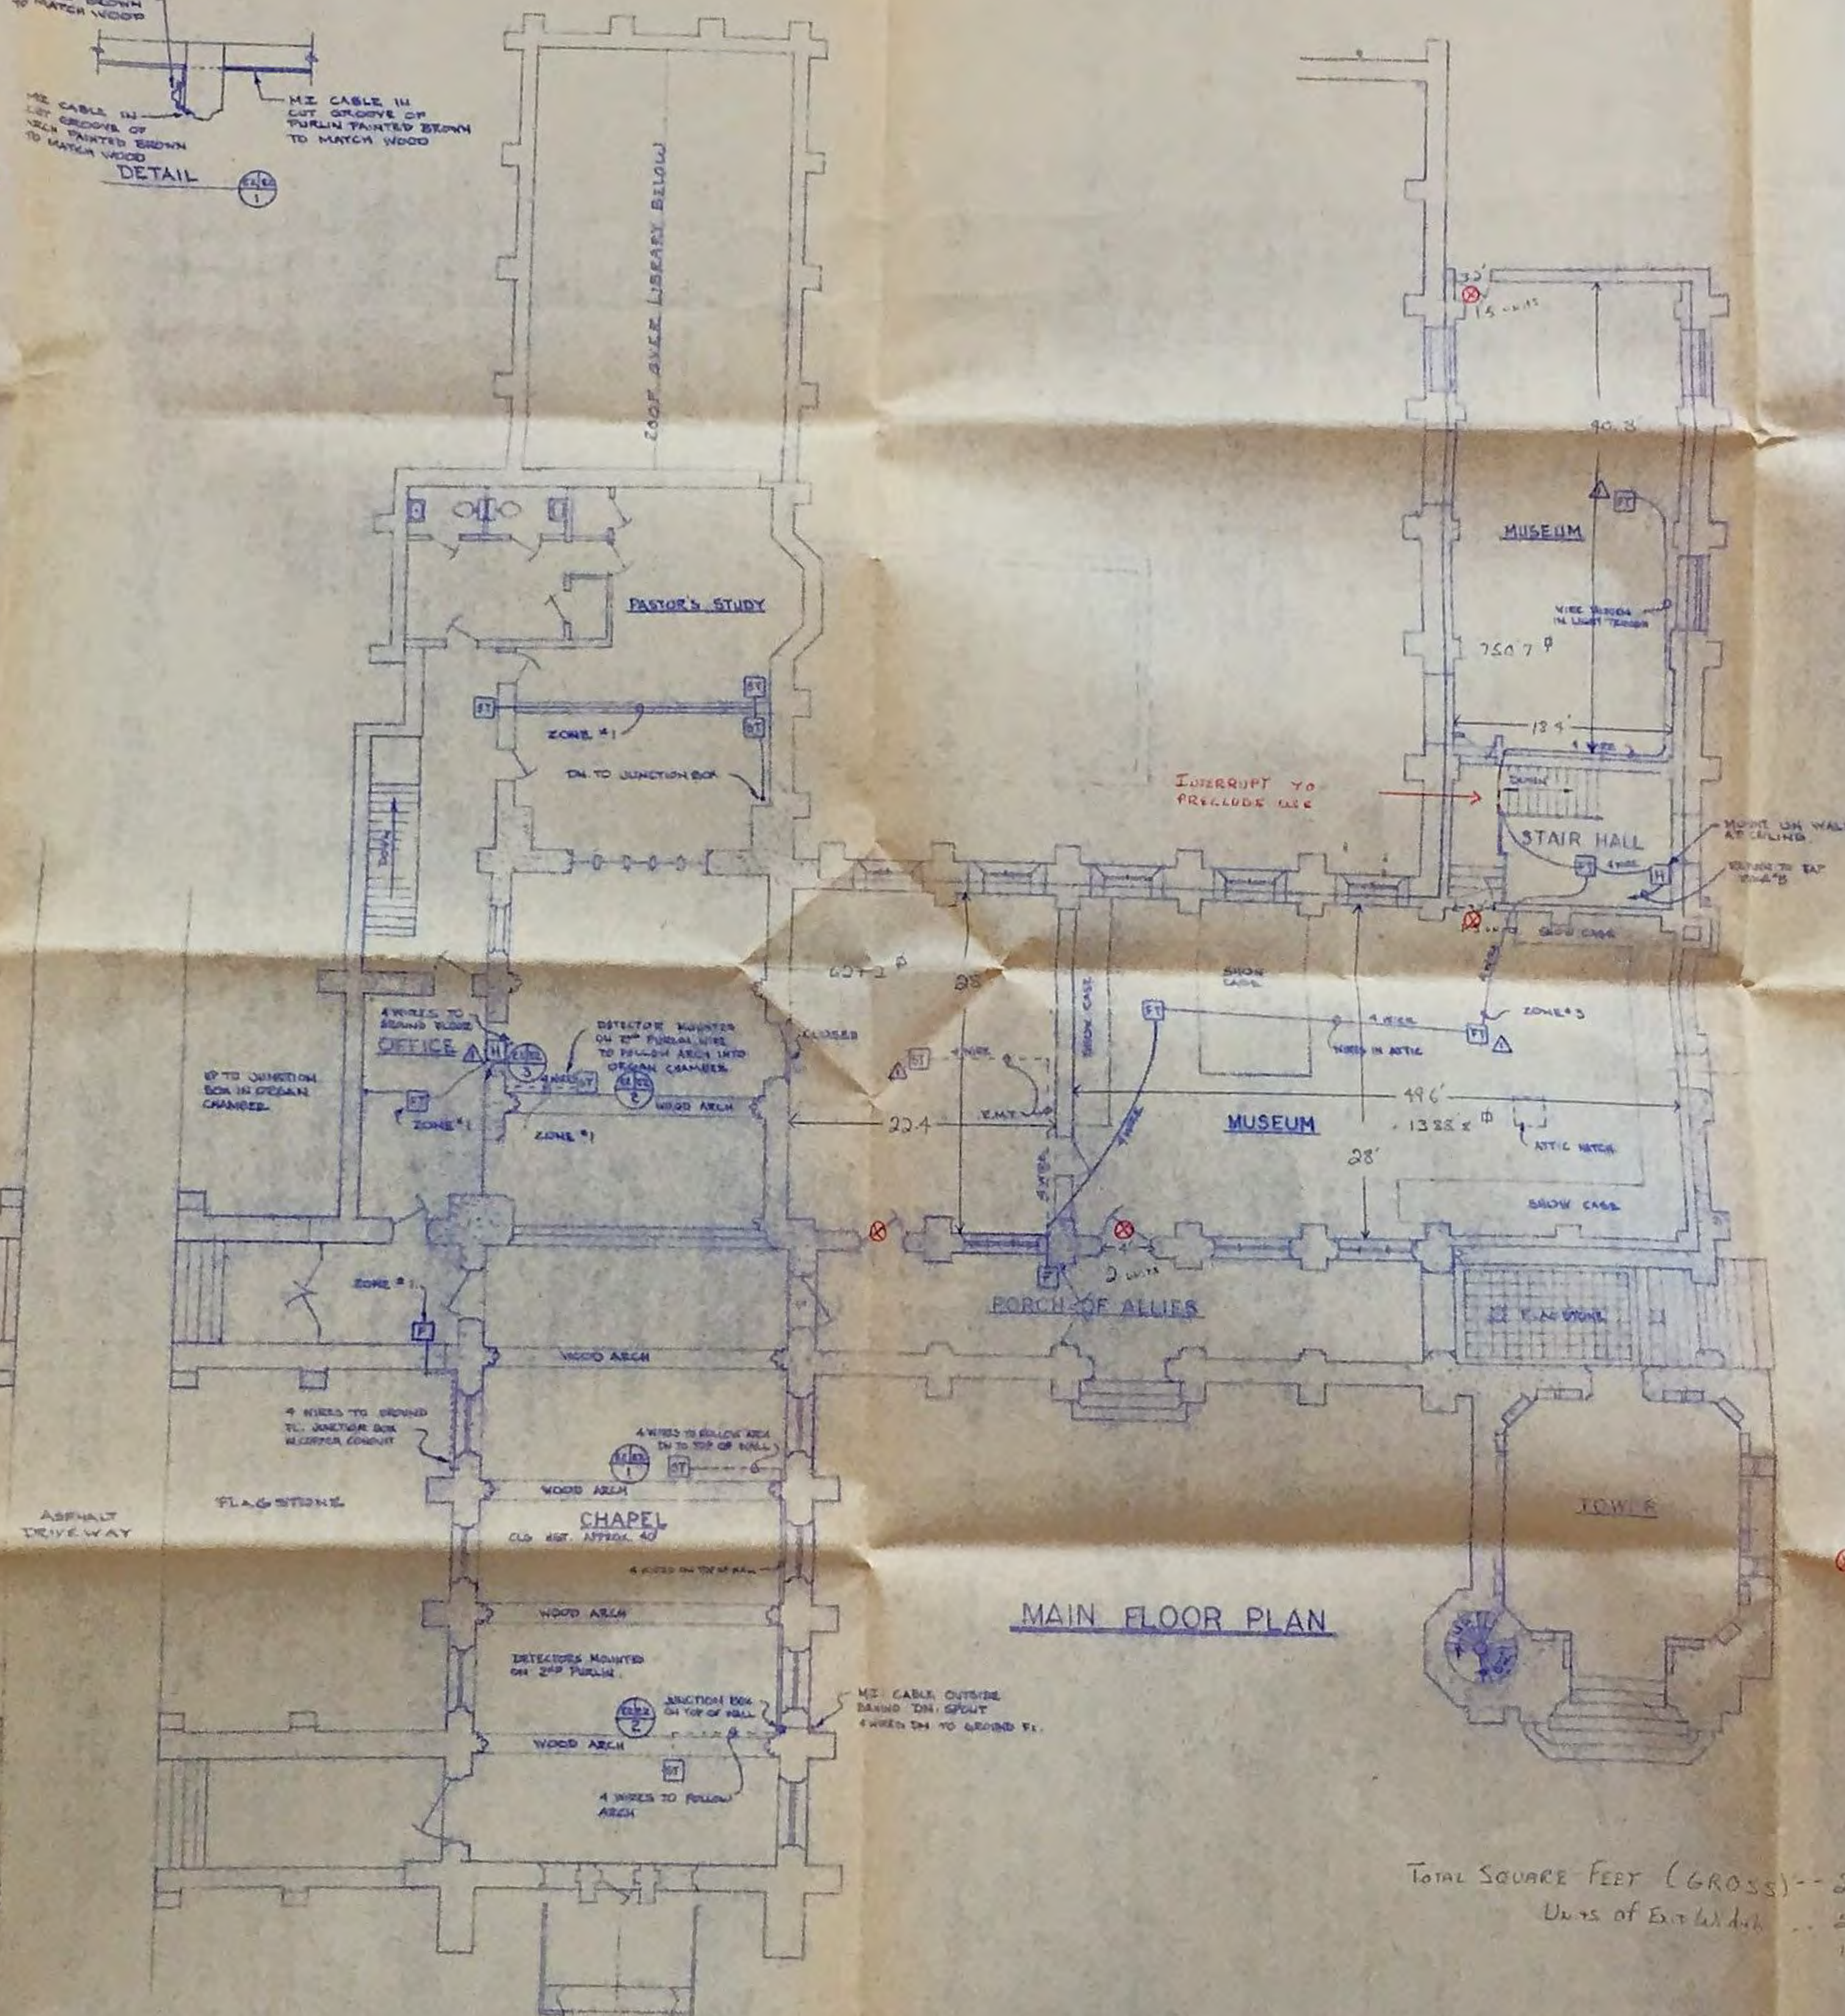

MAIN FLOOR PLAN

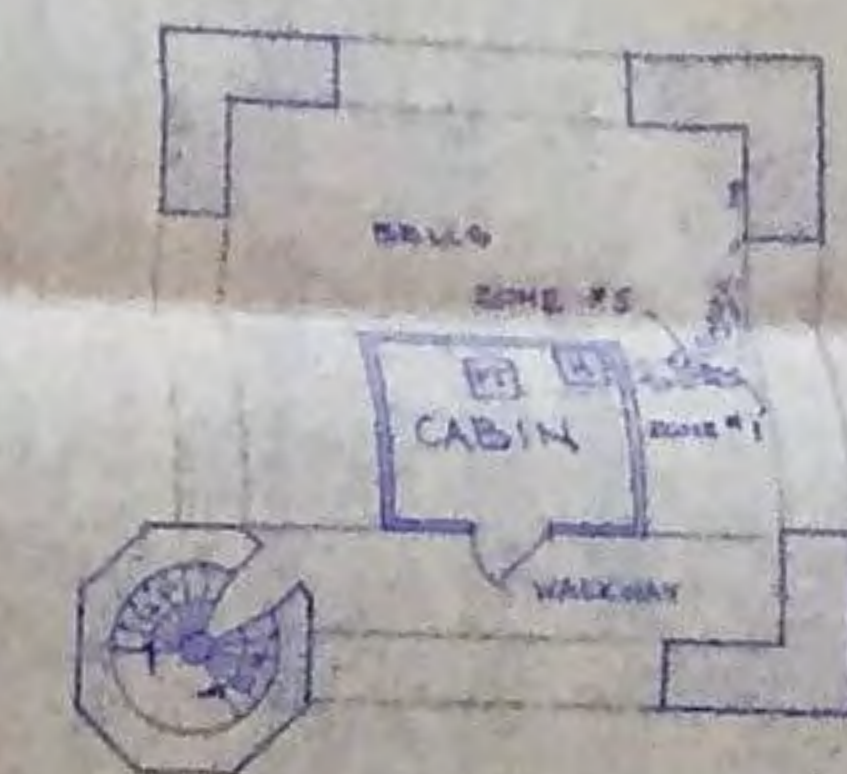

BELL TOWER

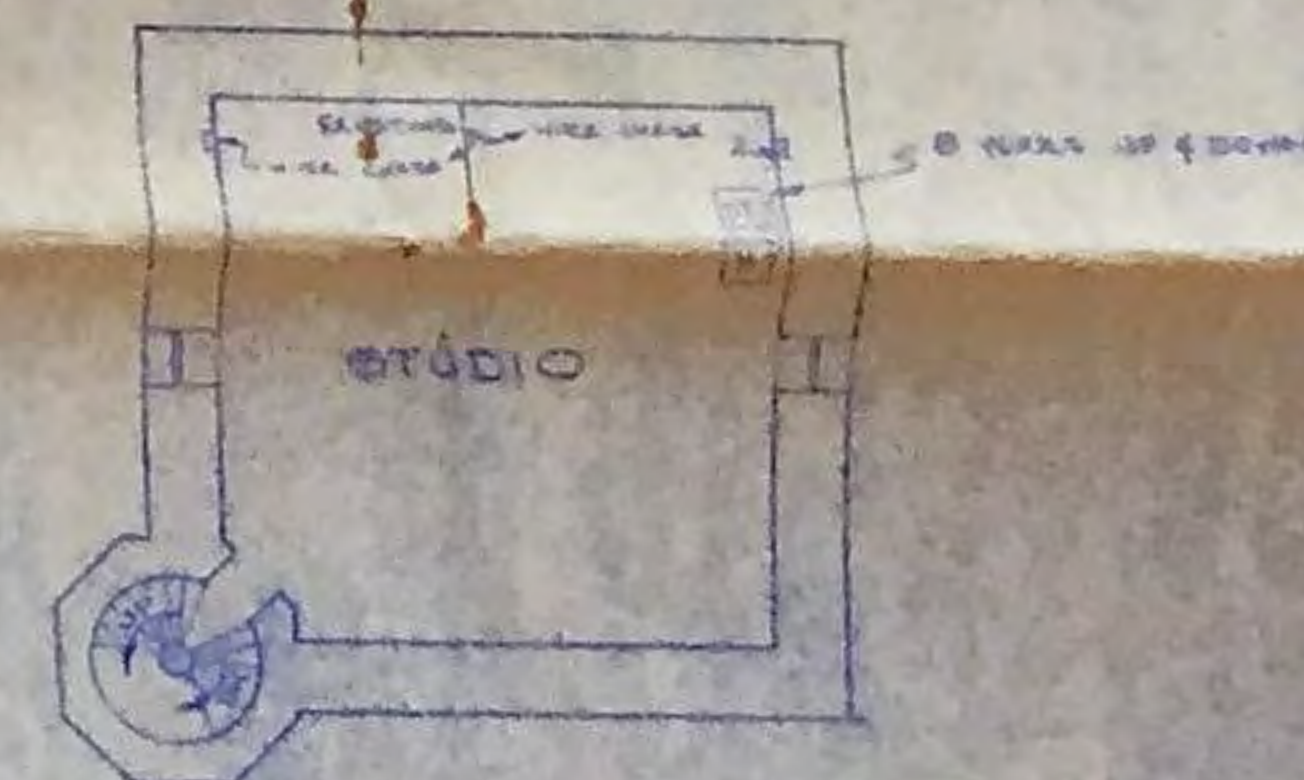

BELL TOWER

④ ILLUMINATED EXIT SIGN (PROVIDE)

TOTAL SQUARE FEET (GROSS) -- 2766.7 Φ

Days of Ext. W. d. h. 2 - horizontal - 200
15 - vertical - 112

AT	100	1000	CHANGES TO AS INSTALLED
Δ		1000	CHANGES DETECTED & REEVALUATE WORK
□			APPROVED FOR CONSTRUCTION
REV	BY	CH/APP	DATE
SCALE			DESCRIPTION
1" = 12'			TITLE
DR. BY	C. E.		MAIN FLOOR PLAN
CM	R. S.		
APP.			
APP.			
			WASHINGTON MEMORIAL CHAPEL VALLEY FORGE, PA.
ATLANTIC ENGINEERS & CONSTRUCTORS KIMBERTON, PA.			DRAWING NUMBER 77-3-E